

SAMPLE IMAGES OF 4 FOOT ALUMINUM PICKET FENCE

JOINT UTILITY LOCATION INFORMATION FOR EXCAVATORS:
CONTRACTORS SHALL CALL THE TOLL FREE J.U.L.I.E. TELEPHONE NUMBER, 1-800-892-0123. OR VISIT WEBSITE
http://www.illinoiscall.com AT LEAST 48 HOURS BEFORE STARTING EXCAVATION.

GATE OR REMOVABLE SECTION, TYP.
PERMEABLE PAVER SERVICE PAD, 25' X 25'

PERMENANT FENCE, TYP.


AMEND, SOD & IRRIGATE ALL SAND PAD AREAS

EXTEND WALKWAY TOWARD THEATER

ENTRY PLAZA OF PERMEABLE PAVERS INTO COMMON GREEN SPACE (NO FENCE)

GATE (SWING OR SLIDING) OR REMOVABLE FENCE SECTION, TYP.

PERMENANT FENCE, TYP.

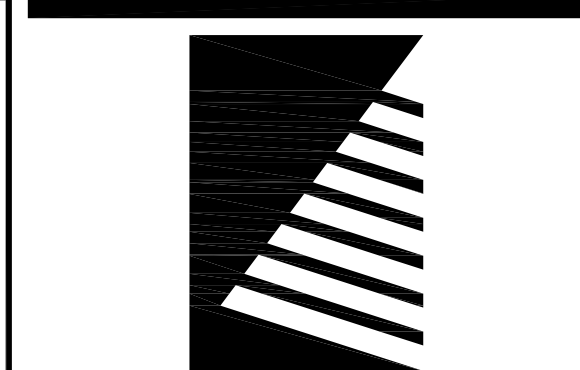

Farnsworth GROUP

7707 N. KNOXVILLE AVE, SUITE 100
PEORIA, ILLINOIS 61614
(309) 689-9888 / info@f-w.com

www.f-w.com
Engineers | Architects | Surveyors | Scientists

ISSUE:
Date: Description:

SITE PLAN REVIEW

PROJECT:
Peoria Civic Center

ANNUAL WINTERFEST SITE - SPRING 2017 IMPROVEMENTS

201 SW Jefferson Ave
Peoria, IL 61602

Date: 11/21/2016

Design/Drawn: -

Reviewed: -

Field Book No.: -

SHEET TITLE:


DRAFT FENCE DIAGRAM

UPDATED:
2017-04-04

SHEET NUMBER:

L2.0

Project No.: 0160203.00

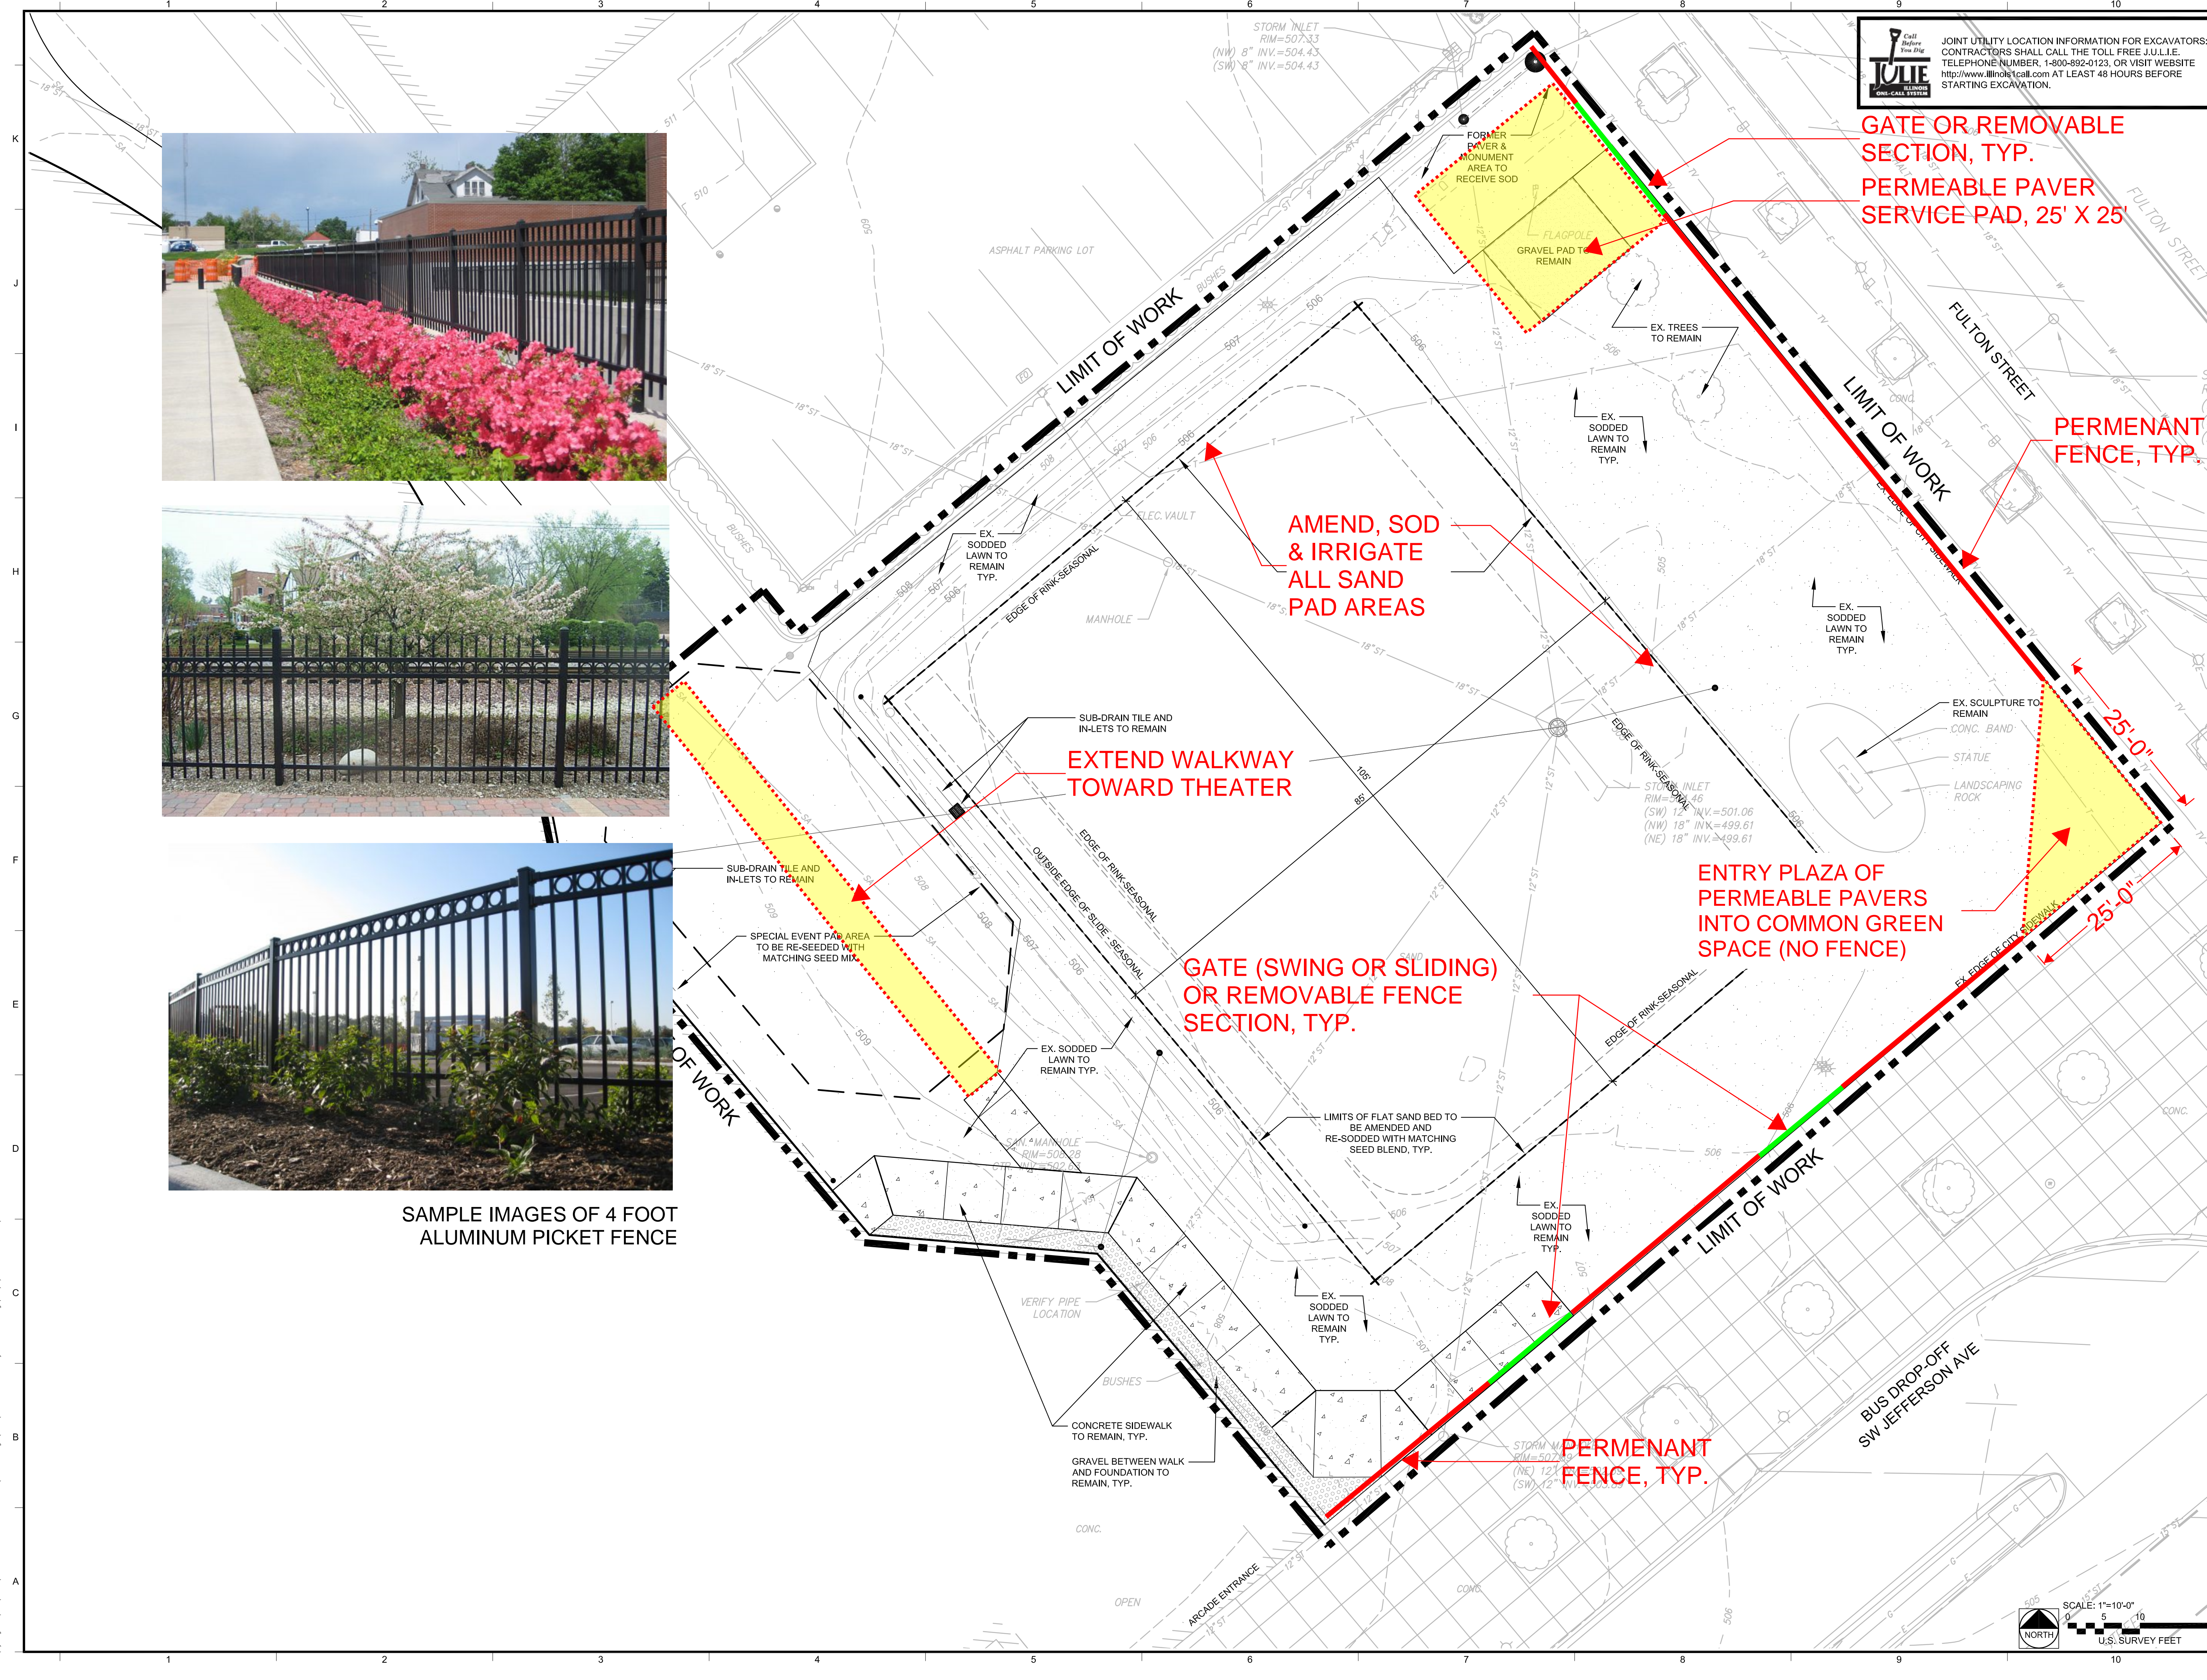

I:\p2016\0160203.00 - PDC - Plaza Site Drawings\DWG\216-Site Plan-City Of Peoria.dwg | 12/7/2016 11:38 AM |